




Lot 10 Plan 2672

Elevation Option 1






Lot 10 Plan 2672

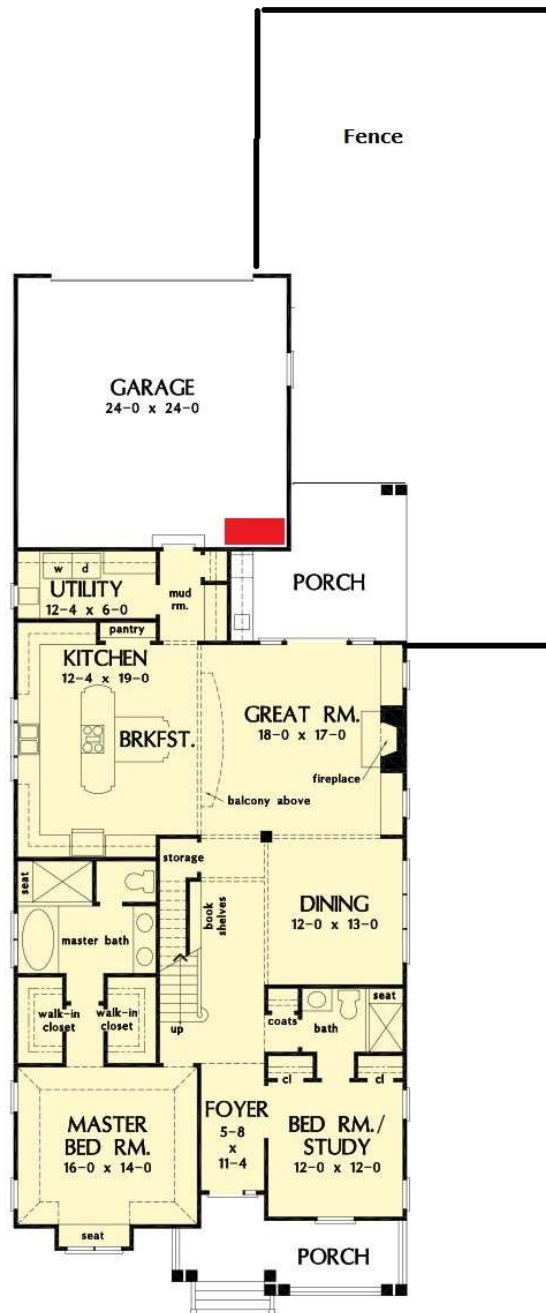

TOTAL SF - 2672
35'0" W X 91'0" D
MAIN LEVEL SF - 1981



Lot 10 Plan 2672

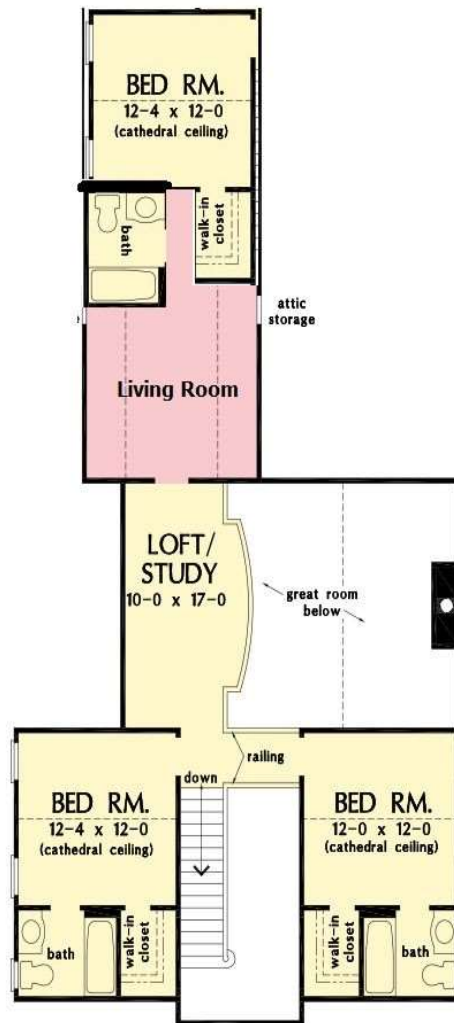

SECOND LEVEL SF - 691
OPTIONAL BONUS ROOM SF - 458



Lot 10 Plan 2672

Lot 8 Skyfall

9265 Skyfall Drive

Main	1,981	4 Bedrooms
Upper	691	4 Full Baths
Bonus	-	
Heated and Cooled	2,672	0 Half Baths
Screen Porch	328	2 Car Garage
Front Porch	189	
Garage	602	35'0" ft wide
	3,791	91'0" ft deep
<i>* As Built Dimensions may vary</i>		
	\$ 593,184	
